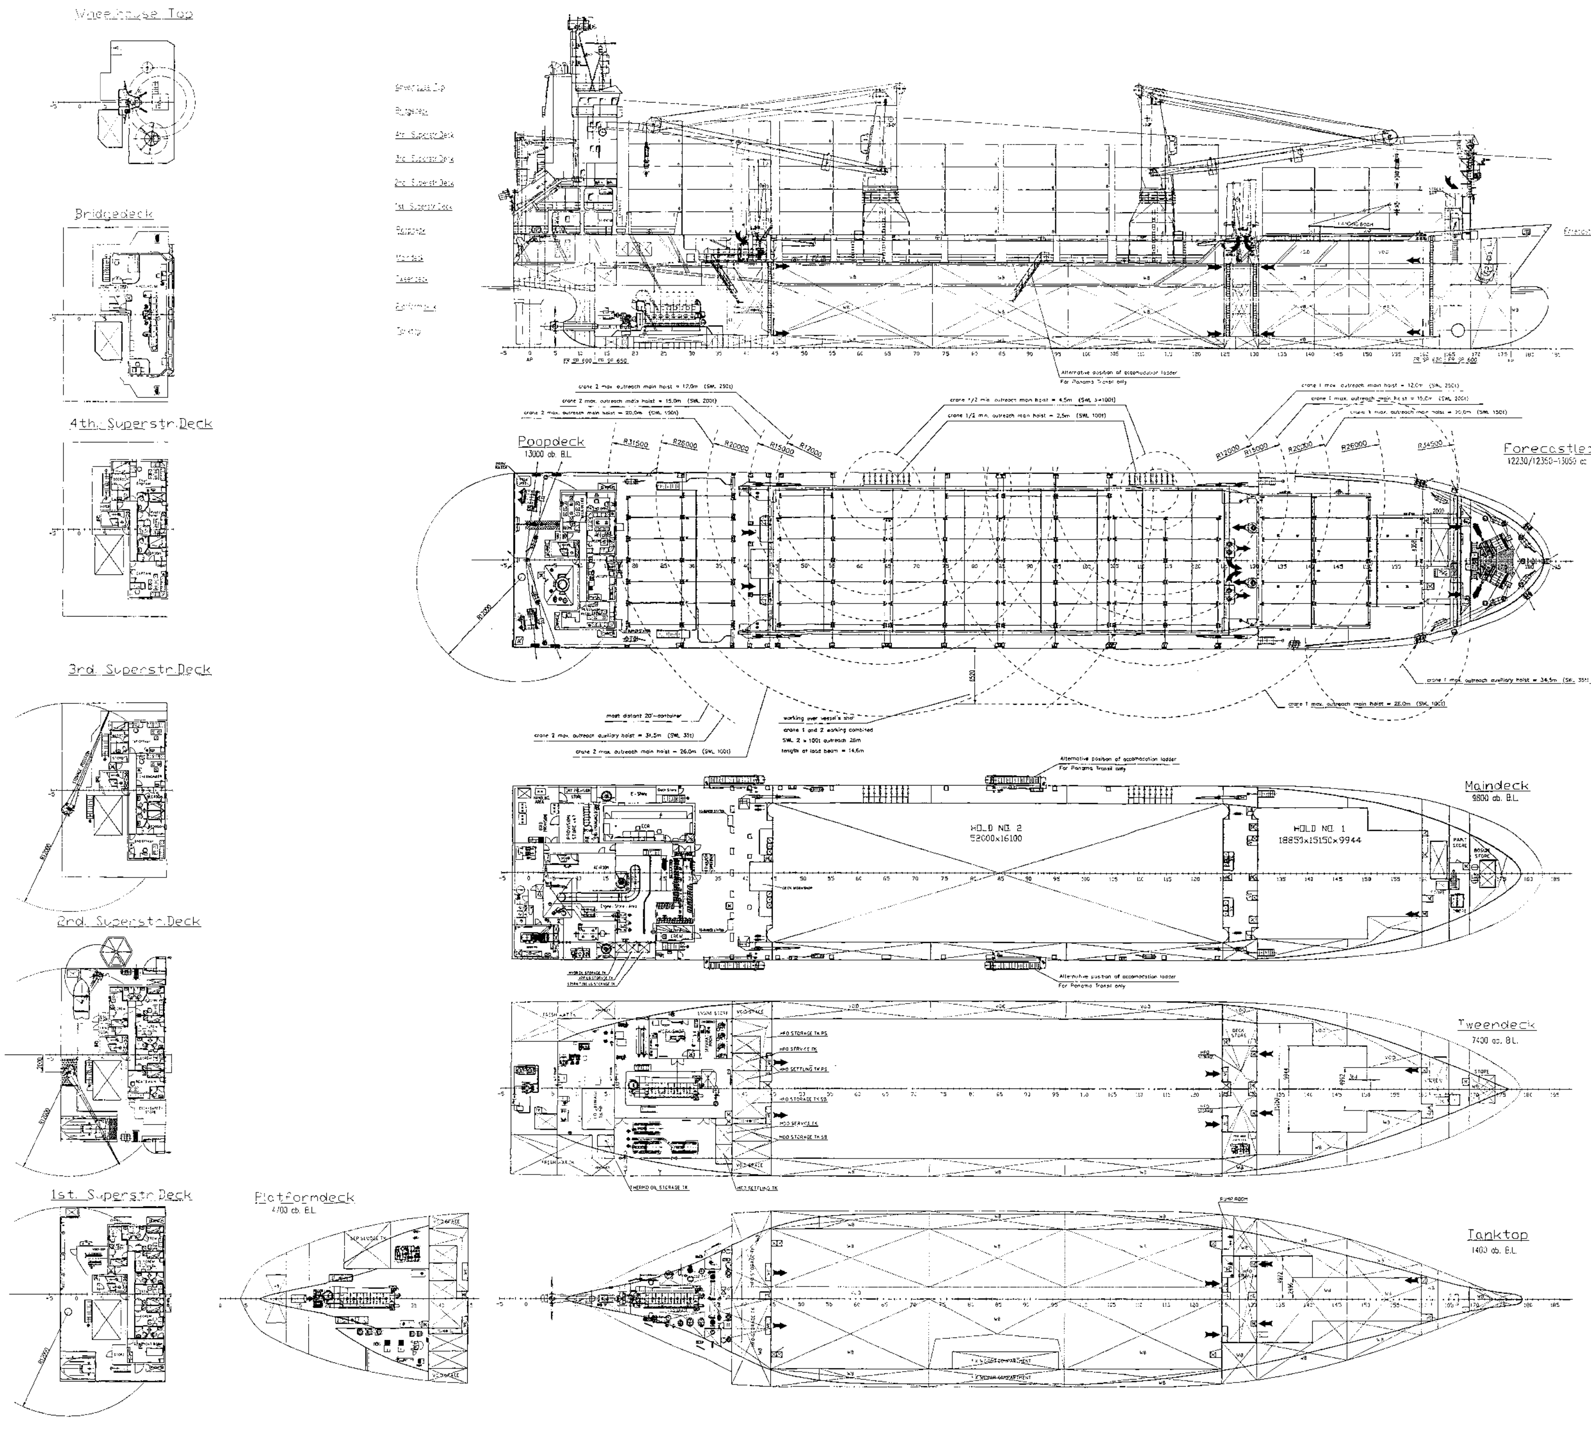
Wheelhouse Top
Bridgedeck
4th. Superstr.Deck
3rd. Superstr.Deck
2nd. Superstr.Deck
1st. Superstr.Deck
Platformdeck
4700 ab. B.L.
Forecastledeck
Alternative position of accomodation ladder
For Panama Transit only
crane 2 max. outreach main hoist = 12,0m (SWL 250t)
crane 2 max. outreach main hoist = 15,0m (SWL 200t)
crane 2 max. outreach main hoist = 20,0m (SWL 150t)
crane 1/2 min. outreach main hoist = 4,5m (SWL 2×100t)
crane 1/2 min. outreach main hoist = 2,5m (SWL 100t)
crane 1 max. outreach main hoist = 12,0m (SWL 250t)
crane 1 max. outreach main hoist = 15,0m (SWL 200t)
crane 1 max. outreach main hoist = 20,0m (SWL 150t)
Poopdeck
13000 ab. B.L.
R31500
R26000
R20000
R15000
R12000
R34500
Forecastledeck
12230/12350-13050 ab. B.L.
most distant 20'-container
crane 2 max. outreach auxiliary hoist = 31,5m (SWL 35t)
crane 2 max. outreach main hoist = 26,0m (SWL 100t)
working over vessel's shell
crane 1 and 2 working combined
SWL 2 × 100t outreach 26m
length of load beam = 14,6m
crane 1 max. outreach main hoist = 26,0m (SWL 100t)
crane 1 max. outreach auxiliary hoist = 34,5m (SWL 35t)
Alternative position of accomodation ladder
For Panama Transit only
Maindeck
9800 ab. B.L.
HOLD NO. 2
52000x16100
HOLD NO. 1
18851x15150x9944
Tweendeck
7400 ab. B.L.
Tanktop
1400 ab. B.L.

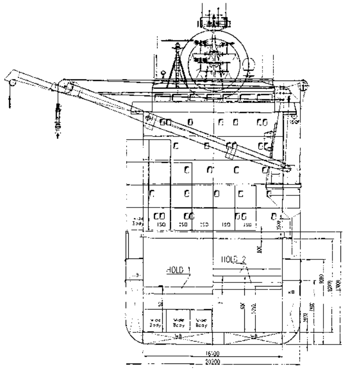

BBC EUROPE

DRAWING AS BUILT SHIP
SHIPYARD
DATE: March 23rd 03

abh INGENIEUR-TECHNIK GMBH

Copyright reserved

Multipurpose Container Heavy Lift Vessel

Class: Germ. Lloyd ✚ 100 A5 E G ✚ MC AUT 24/24 E
"EQUIPPED FOR CARRIAGE OF CONTAINERS"
"SOLAS II Reg. 54"

MAIN DIMENSIONS

LENGTH OVER ALL	ABT.	119.80 m
LENGTH BETWEEN PERPENDICULARS	ABT.	113.50 m
BREADTH MOULDED		20.20 m
DEPTH TO MAINDECK	ABT.	9.80 m
DEPTH TO TWEENDECK		7.40 m
SCANTLING DRAUGHT	ABT.	7,60 m
DESIGN DRAUGHT	ABT.	7,00 m
CARGO HOLD CAPACITY	ABT.	11500 m³
ENGINE OUTPUT		6300 KW
SPEED (at 85% MCR)		16.50 KN

REV	ALTERATION	DATE	NAME	REV	ALTERATION	DATE	NAME
E	ADDITIONAL POS. FOR ACCOMODATION LADDER	14.11.02	[illegible]				
C	SEVERAL ALTERATION	15.01.02	JANSSEN	D	STAB PONTOON ADDED	30.04.02	[illegible]
A	SUP STR. HATCHES, DIFF. DETAILS	13.09.01	JANSSEN	B	SEVERAL ALTERATION	28.11.01	JANSSEN

abh
INGENIEUR-TECHNIK GMBH

THIS DRAWING MAY NOT BE COPIED NOR HANDED OVER TO THIRD PARTIES OR COMPETITORS WITHOUT OUR WRITTEN CONSENT

SCALE 1:200

PROJECT
GENERAL ARRANGEMENT
PLAN

DRAWING NO. 0879/01-0001

NUMBER OF SHEETS 1
SHEET NO. 1